




*Seal off  
 annular space  
 of ends  
 to conform with A.E.D.A.*

NOTE: All wyes and Laterals to be Located in the field  
 All manholes other than Drops to be Riv. Std. No 500  
 Joints in 15" V.C.P. laid in 24" conductor pipe will be the prepared plastic type as approved by the City Engineer.  
 Contractor must enter into Santa Fe R.R. Co "Save Harmless Letter Agreement" prior to construction under track, except that additional policies under Para. 2(c) will not be required. A copy of this agreement is on file in Public Works Office  
 Any expenses incurred by the Santa Fe as a result of this construction shall be billed to the Contractor.  
 The Santa Fe R.R. Co. will require 48 hours notice prior to construction under the track in order to arrange inspection and supervision.

*J. J. Anderson* 3-20-59  
 SEWER  
 HARRISON ST. (TRUNK LINE) INDIANA AVE. TO FOX ST.  
 WOOD HAVEN ESTATES  
 1" = 40' 1" = 40'

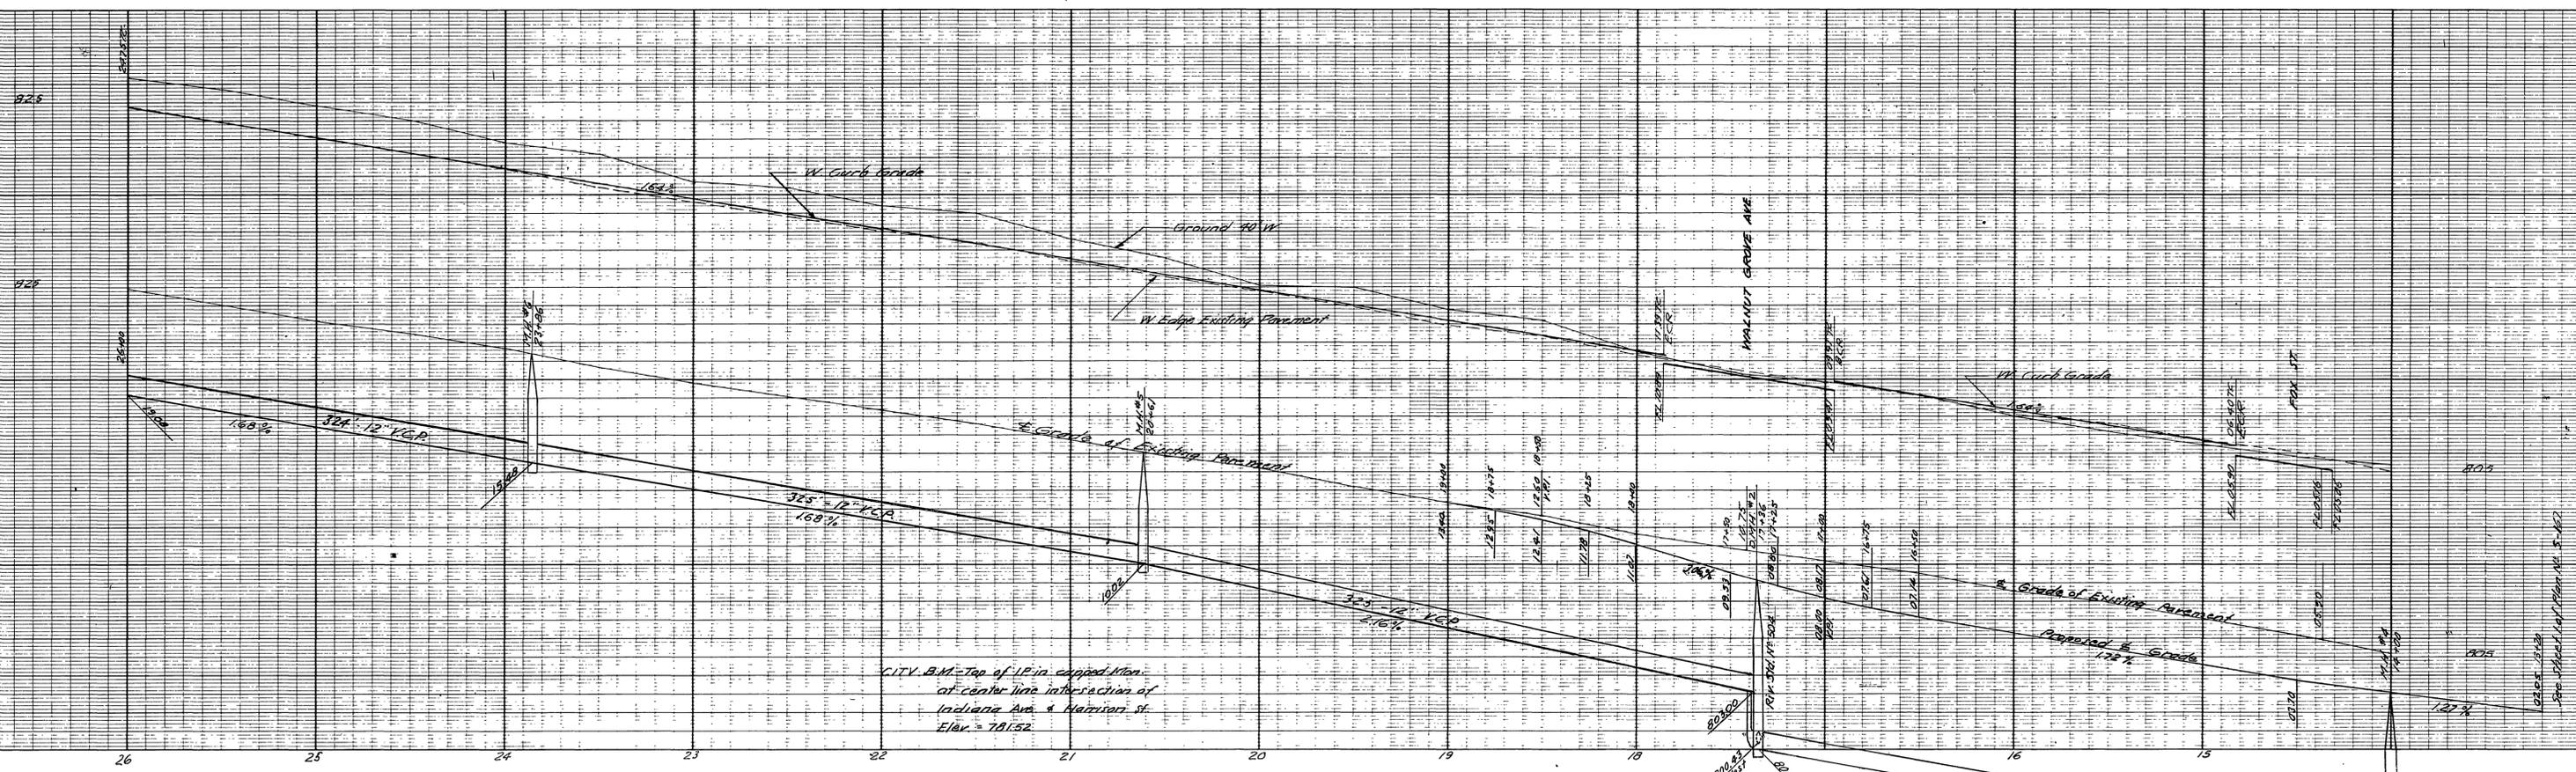

CITY B.M. - Top of IP in capped Man. at center line intersection of Indiana Ave. & Harrison St. Elev. = 781.52.

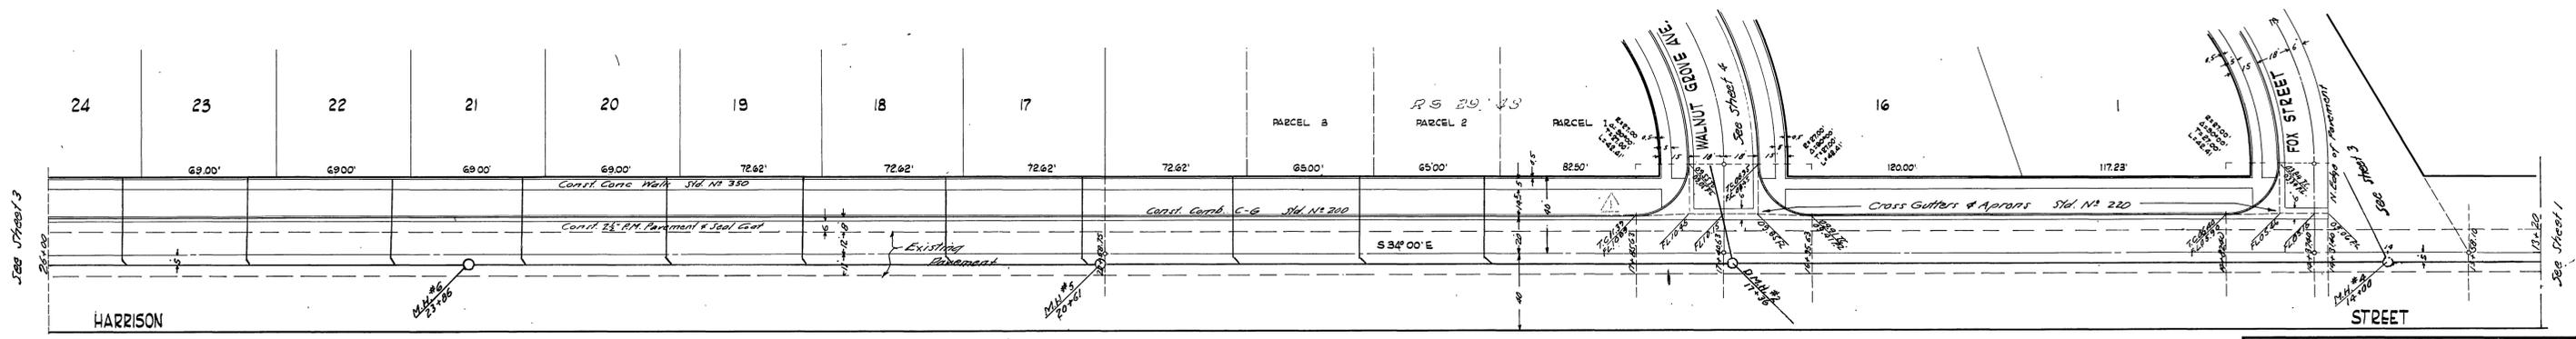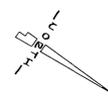

NOTE: All wyss and laterals to be located in the field  
Manholes to be Riverside City SW # 300, except drops.

NO.	DATE	REVISIONS
1	7/14/59	REVISION
2	7/14/59	REVISION
J. F. DAVIDSON - CIVIL ENGINEER  
 R.E. No 862  
 RIVERSIDE, CALIFORNIA  
 APPROVED BY *J. F. Davidson* DATE 7-10-59

CITY OF RIVERSIDE, CALIFORNIA  
 DEPARTMENT OF PUBLIC WORKS

SEWER PLAN & PROFILE  
 HARRISON STREET  
 WOODHAVEN ESTATES

HORIZ. SCALE 1" = 40' VERT. SCALE 1" = 4'


APPROVED BY *Francis J. Lefcher*  
 Director of Public Works

NO. S-167  
 DATE 7/14/59 SHEET 2 OF 5



See Sheet 3

See Sheet 1

Beinh. Cont. #35

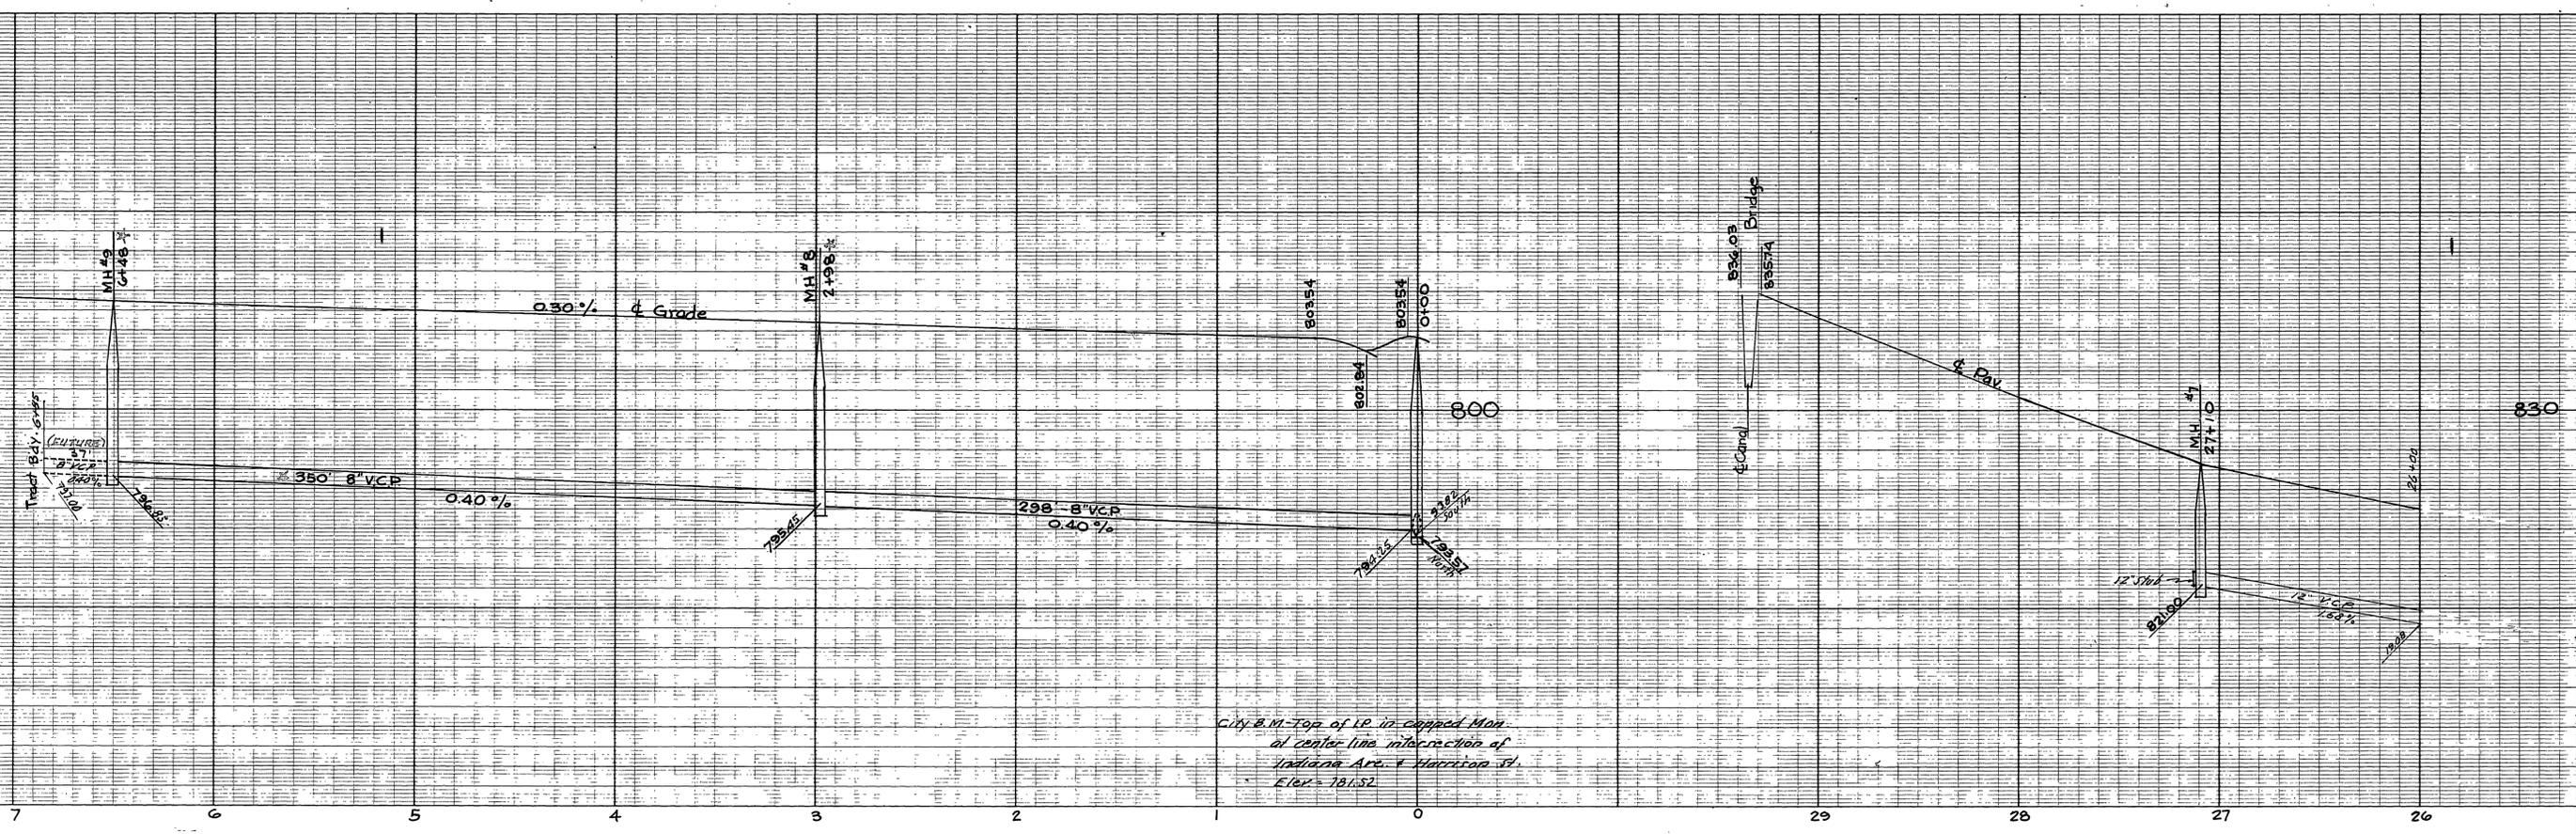



City B.M. Top of IR in capped Man  
at center line intersection of  
Indiana Ave. & Harrison St.  
Elev = 101.52

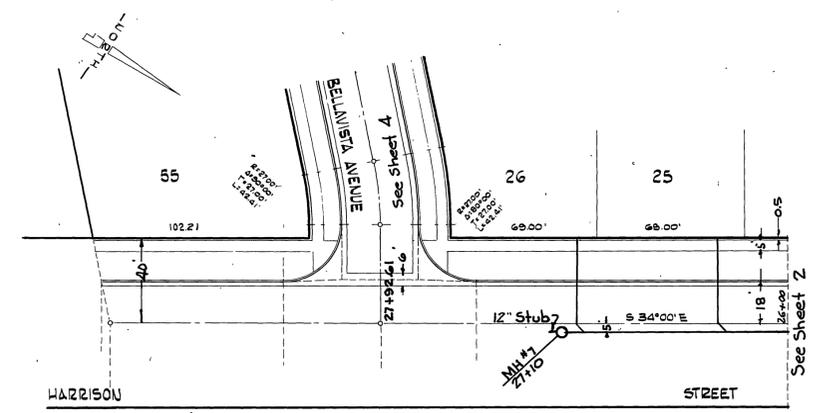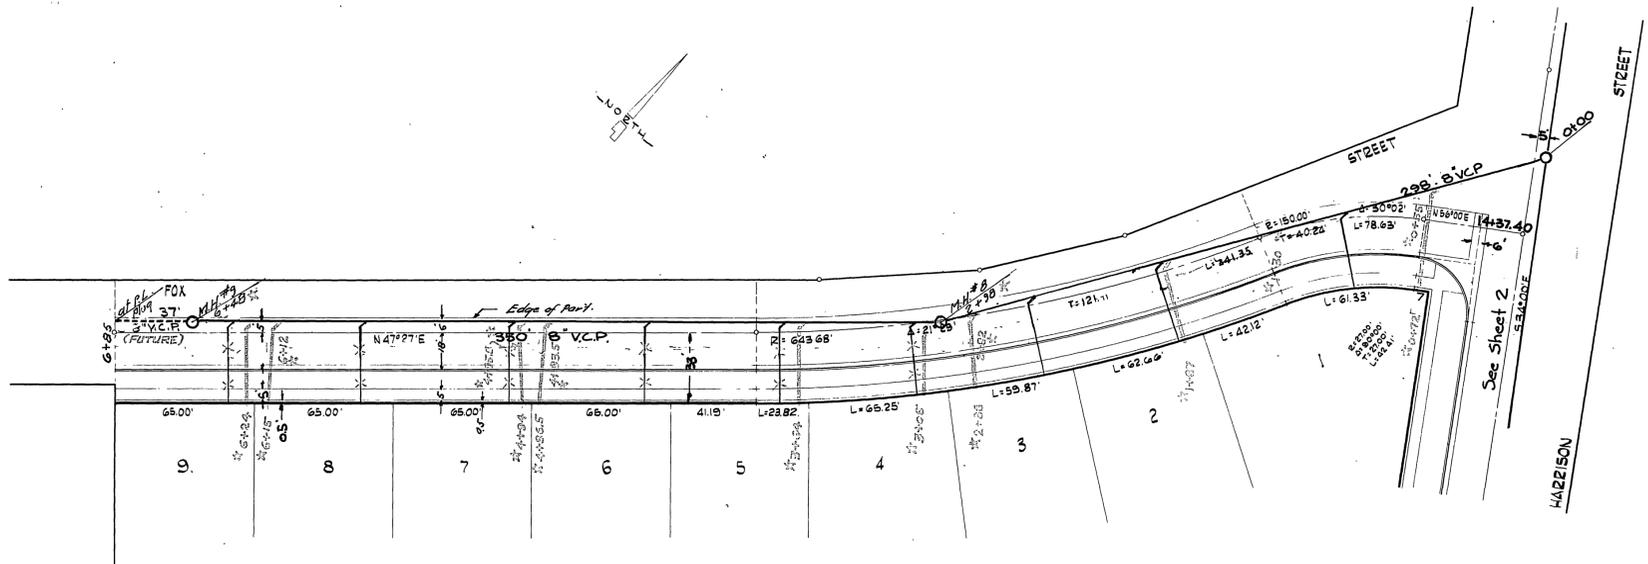



NOTE: All wyes and Laterals to be Located in the field.  
Manholes to be Riverside City Std. No 500

J. F. DAVIDSON - CIVIL ENGINEER R.E. No 862 RIVERSIDE, CALIFORNIA	
APPROVED BY: <i>J. F. Davidson</i> DATE: 3-20-59	
CITY OF RIVERSIDE, CALIFORNIA DEPARTMENT OF PUBLIC WORKS	
SEWER PLAN & PROFILE HARRISON STREET FOX STREET	
WOODHAVEN ESTATE HORIZ. SCALE 1" = 40' VERT. SCALE 1" = 4'	
APPROVED BY: <i>Francis S. Zeller</i> Director of Public Works	NO. S-167
DATE: 2/16/59	SHEET 3 OF 5

\* "As Built" 8-5-59, H.B.M.

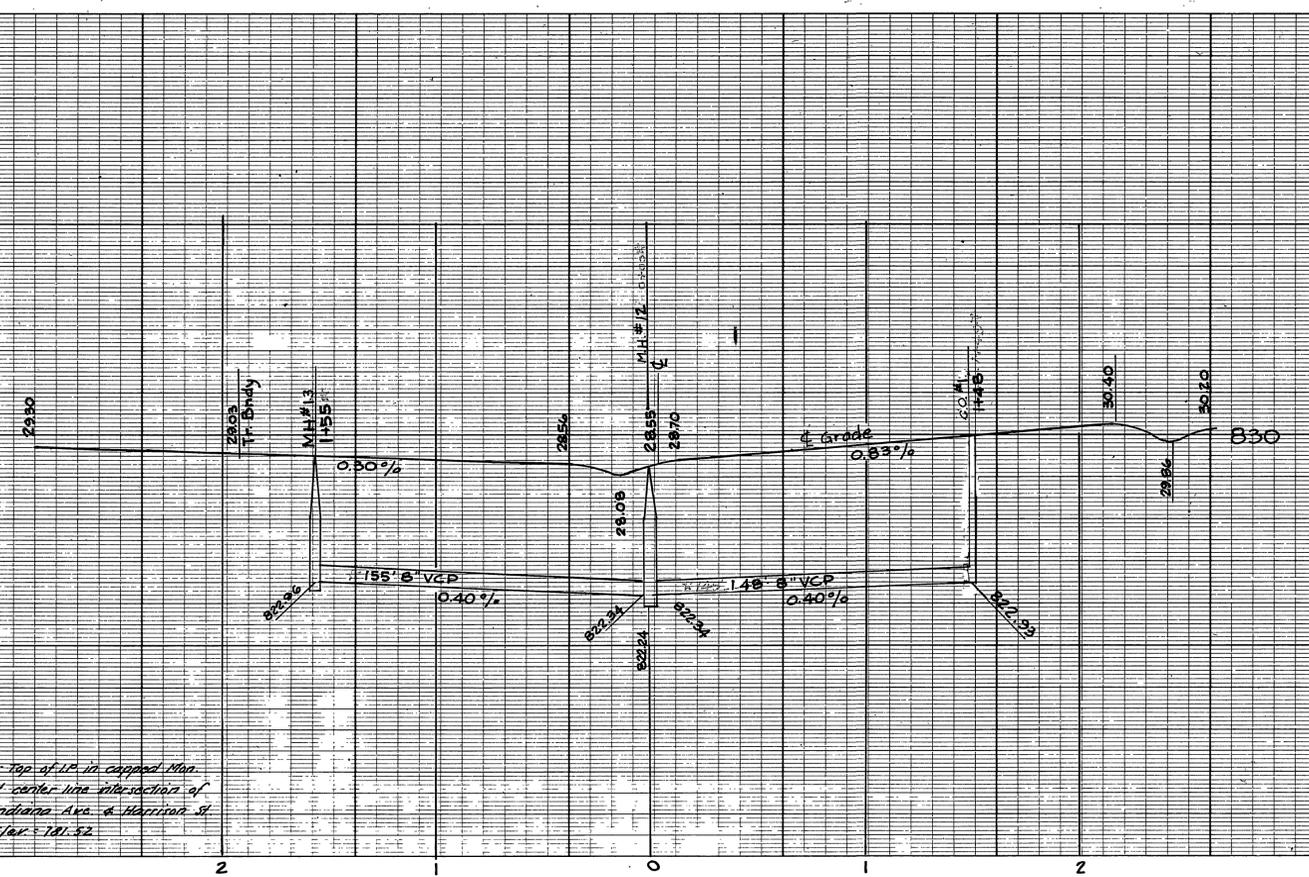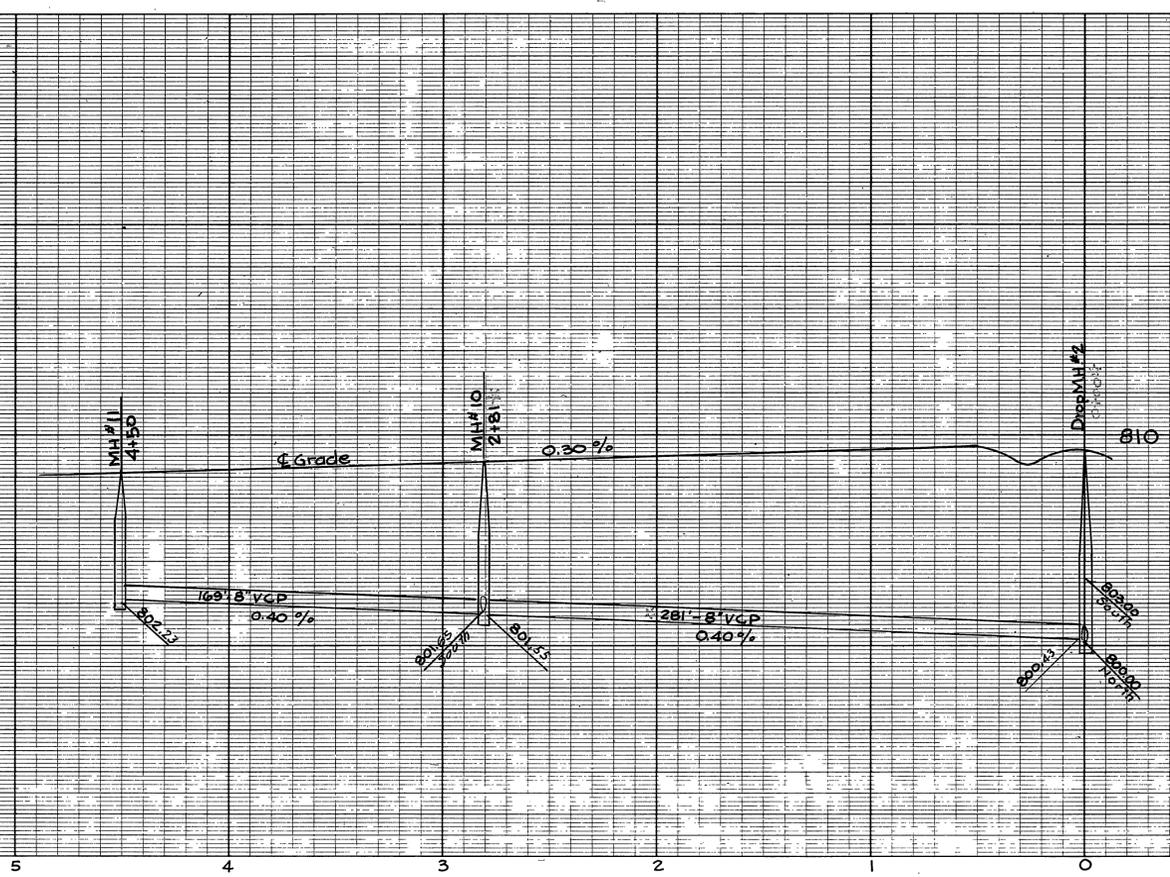



City & M. Top of 12" in capped Man. at center line intersection of Indiana Ave. & Harrison St. Elev. = 181.32

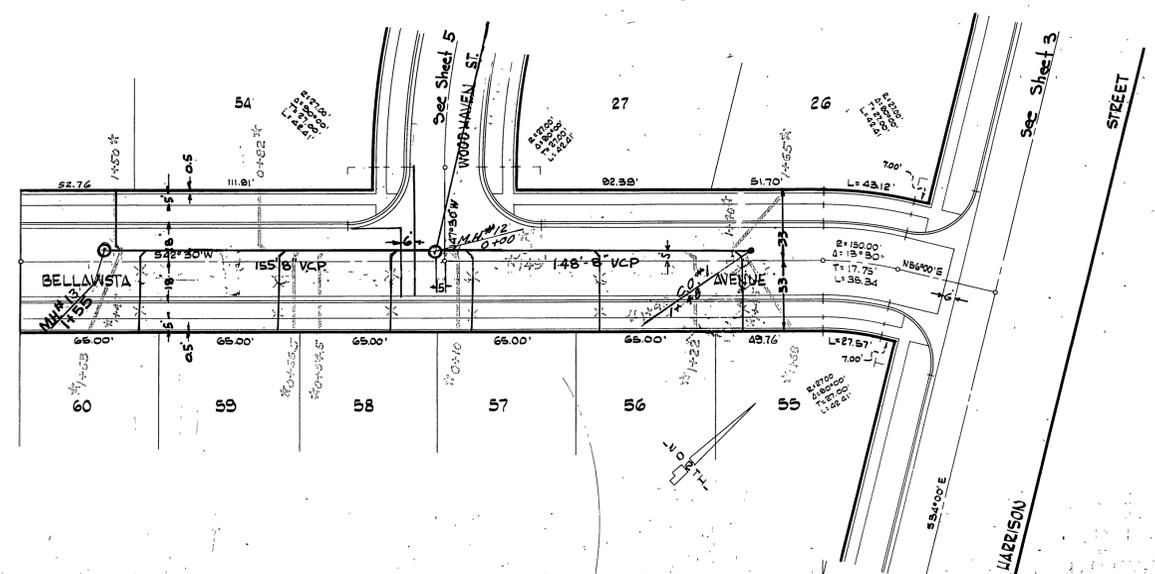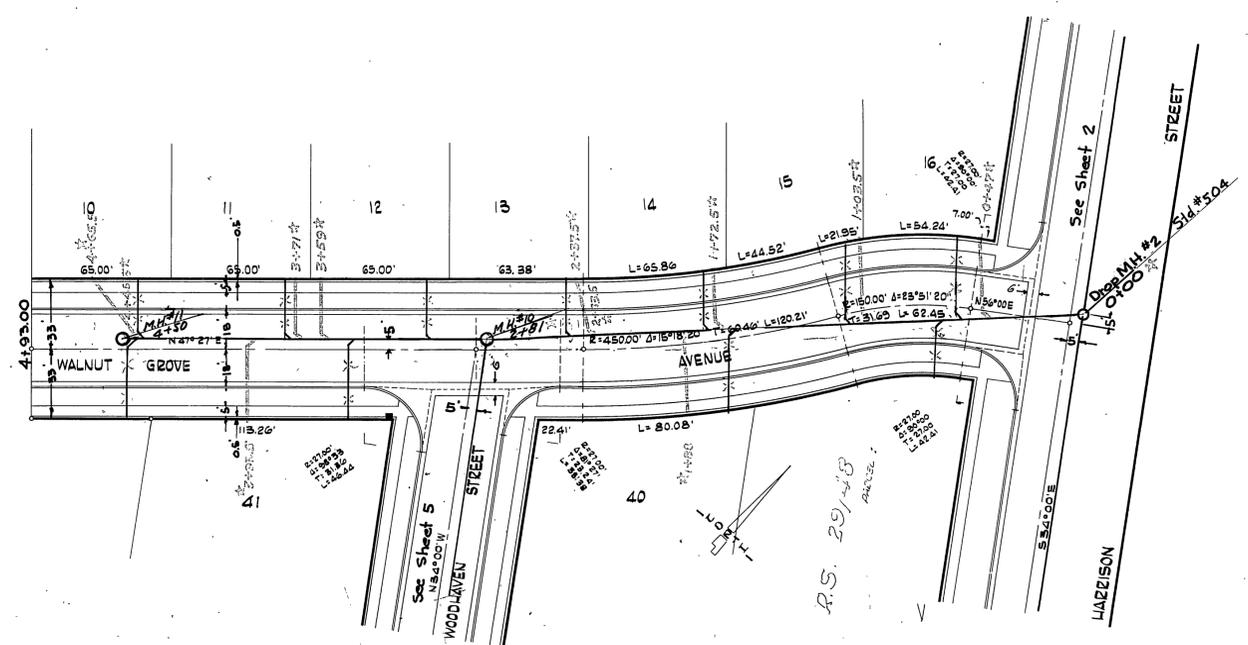

NOTE: All wyes and laterals to be located in the field.  
Manholes except Drops to be Riverside City Std. No. 500  
Cleanouts to be Riverside City Std. No. 500

\* = "As Built" 8-5-53, H.B.G.H.

<b>J.F. DAVIDSON - CIVIL ENGINEER</b> R.E. No. 862 RIVERSIDE, CALIFORNIA APPROVED BY <i>J.F. Davidson</i> DATE 2-20-59		<b>SEWER PLAN &amp; PROFILE</b> BELLAVISTA AVENUE WALNUT GROVE AVENUE	
CITY OF RIVERSIDE, CALIFORNIA DEPARTMENT OF PUBLIC WORKS		WOODHAVEN ESTATES HORIZ. SCALE 1"=40' VERT. SCALE 1"=40'	
APPROVED BY <i>Francis J. Tolber</i> Director of Public Works		NO. S-167	
DATE 4/16/59		SHEET 4 OF 5	

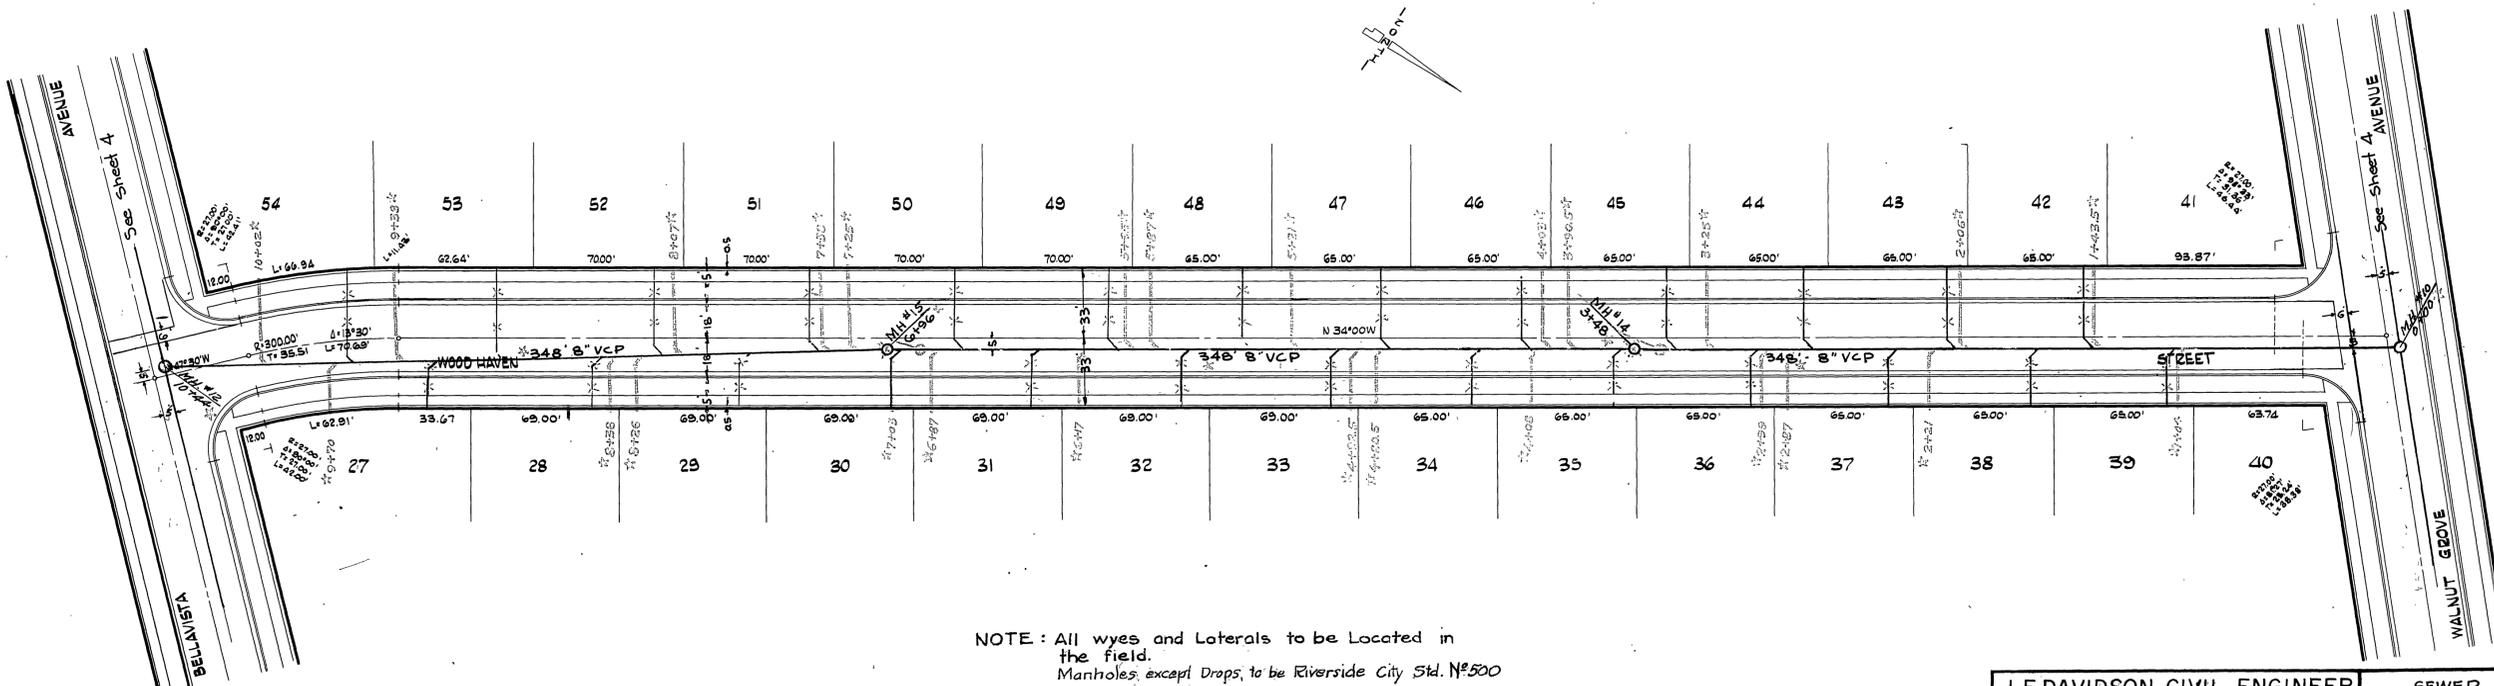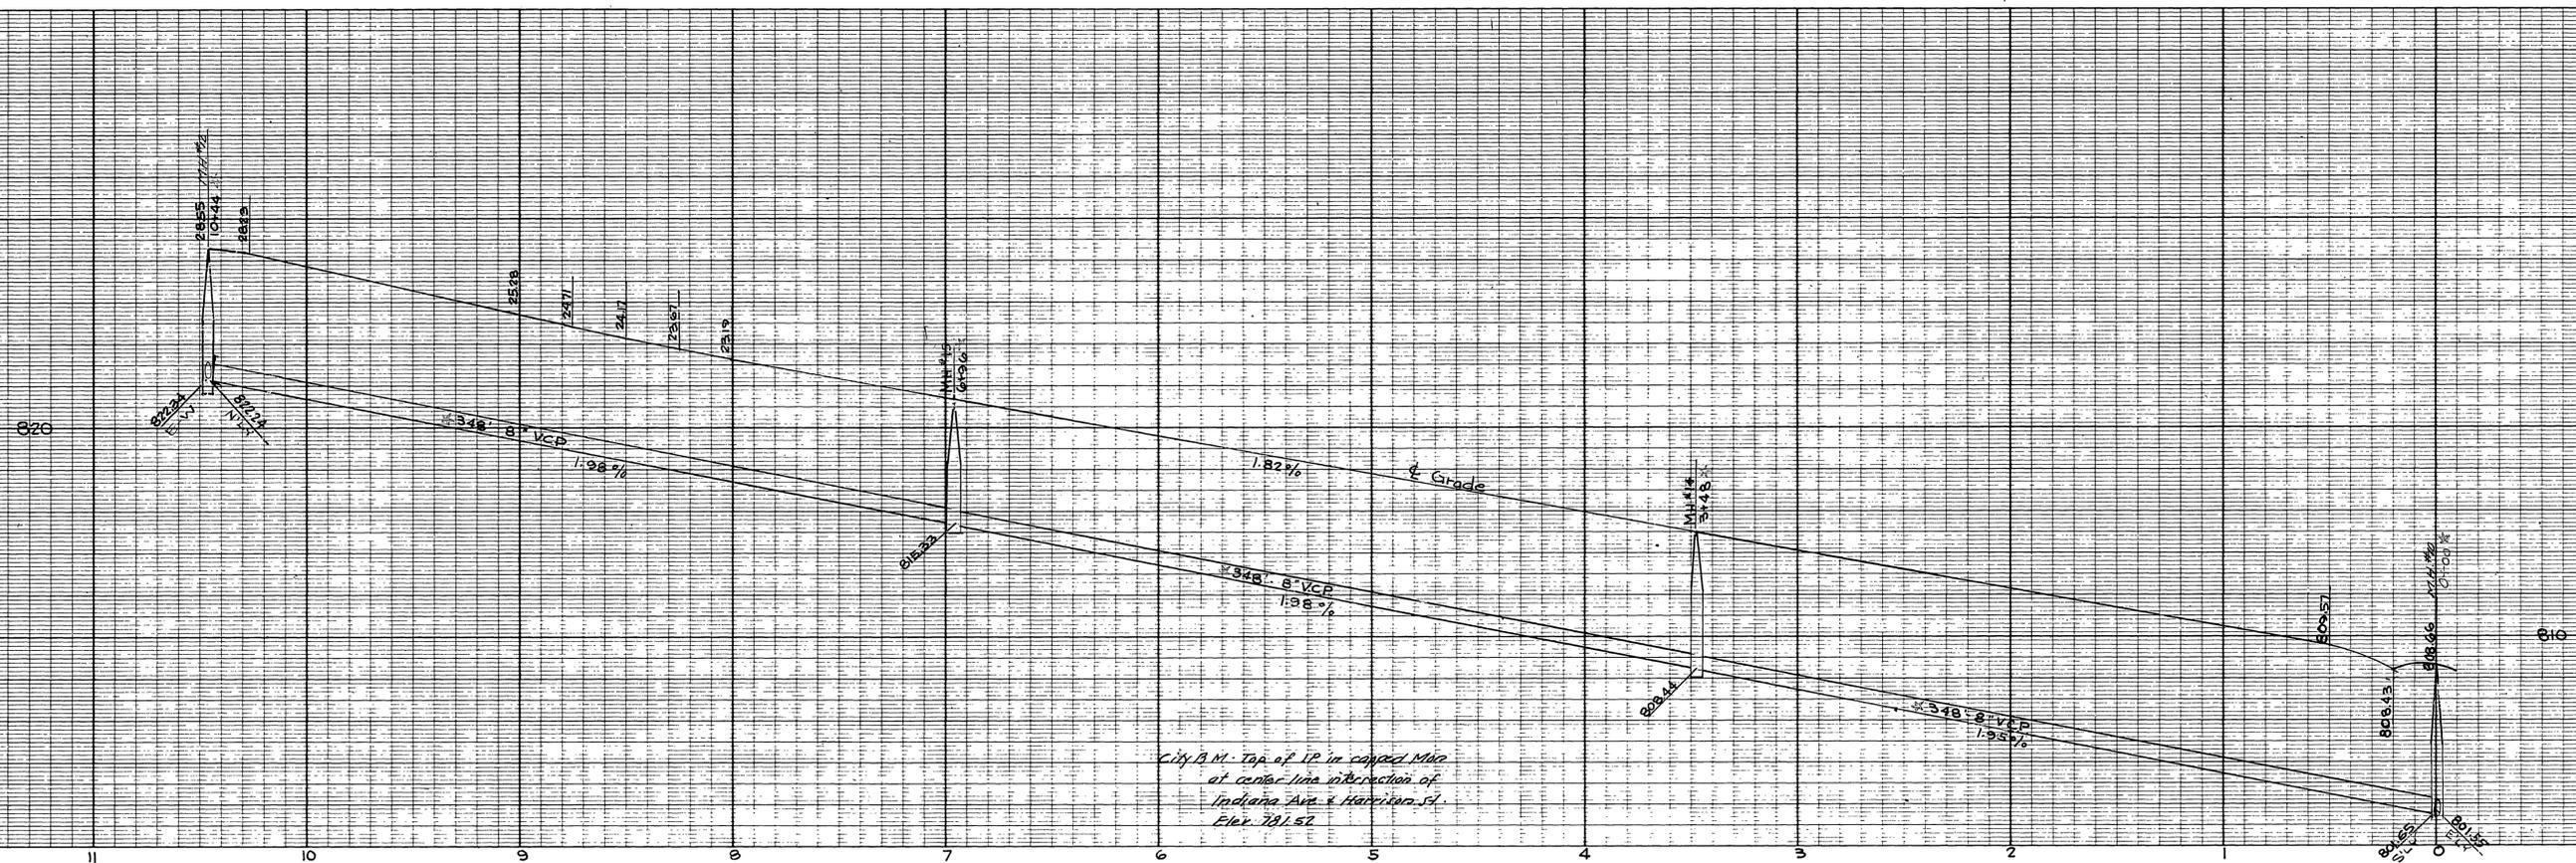

NOTE: All wyes and Laterals to be Located in the field.  
 Manholes, except Drops, to be Riverside City Std. No. 500

\* = "As Built" 8-4-53, H. Ball

<b>J. F. DAVIDSON - CIVIL ENGINEER</b> R.E. No. 862 RIVERSIDE, CALIFORNIA		<b>SEWER PLAN &amp; PROFILE</b> WOOD HAVEN STREET WOODHAVEN ESTATES	
APPROVED BY: <i>J. Davidson</i> DATE: 3-20-53		HORIZ. SCALE 1"=40' VERT. SCALE 1"=4'	
CITY OF RIVERSIDE, CALIFORNIA DEPARTMENT OF PUBLIC WORKS		APPROVED BY: <i>James J. Latta</i> Director of Public Works	
DATE: 4/6/53		NO. S-167 SHEET 5 OF 5	